




Figure 1-Facility Plot Plan

Minimum Security

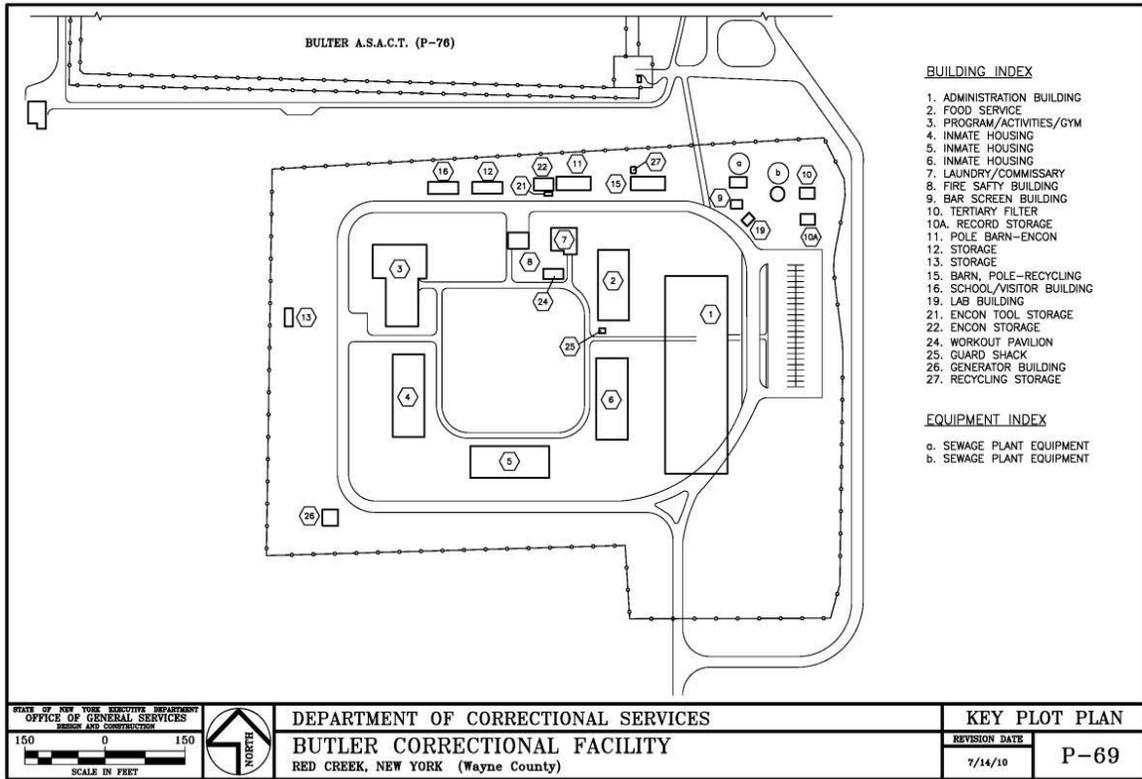

Medium Security

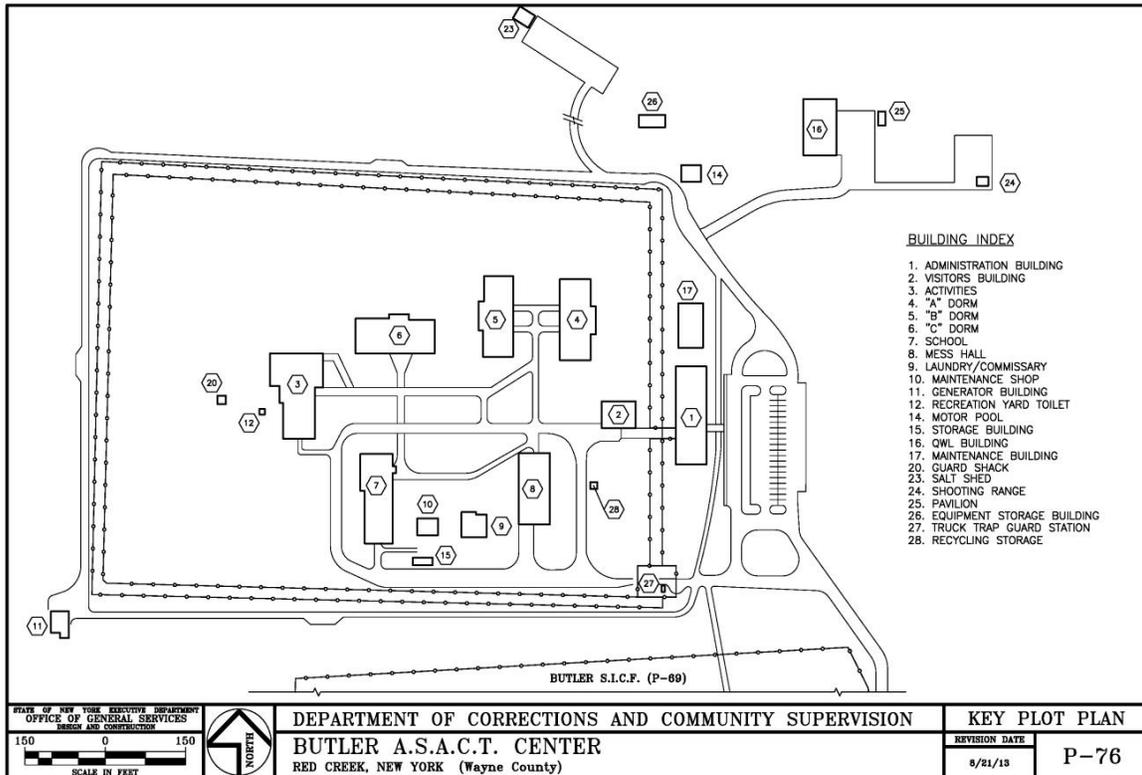

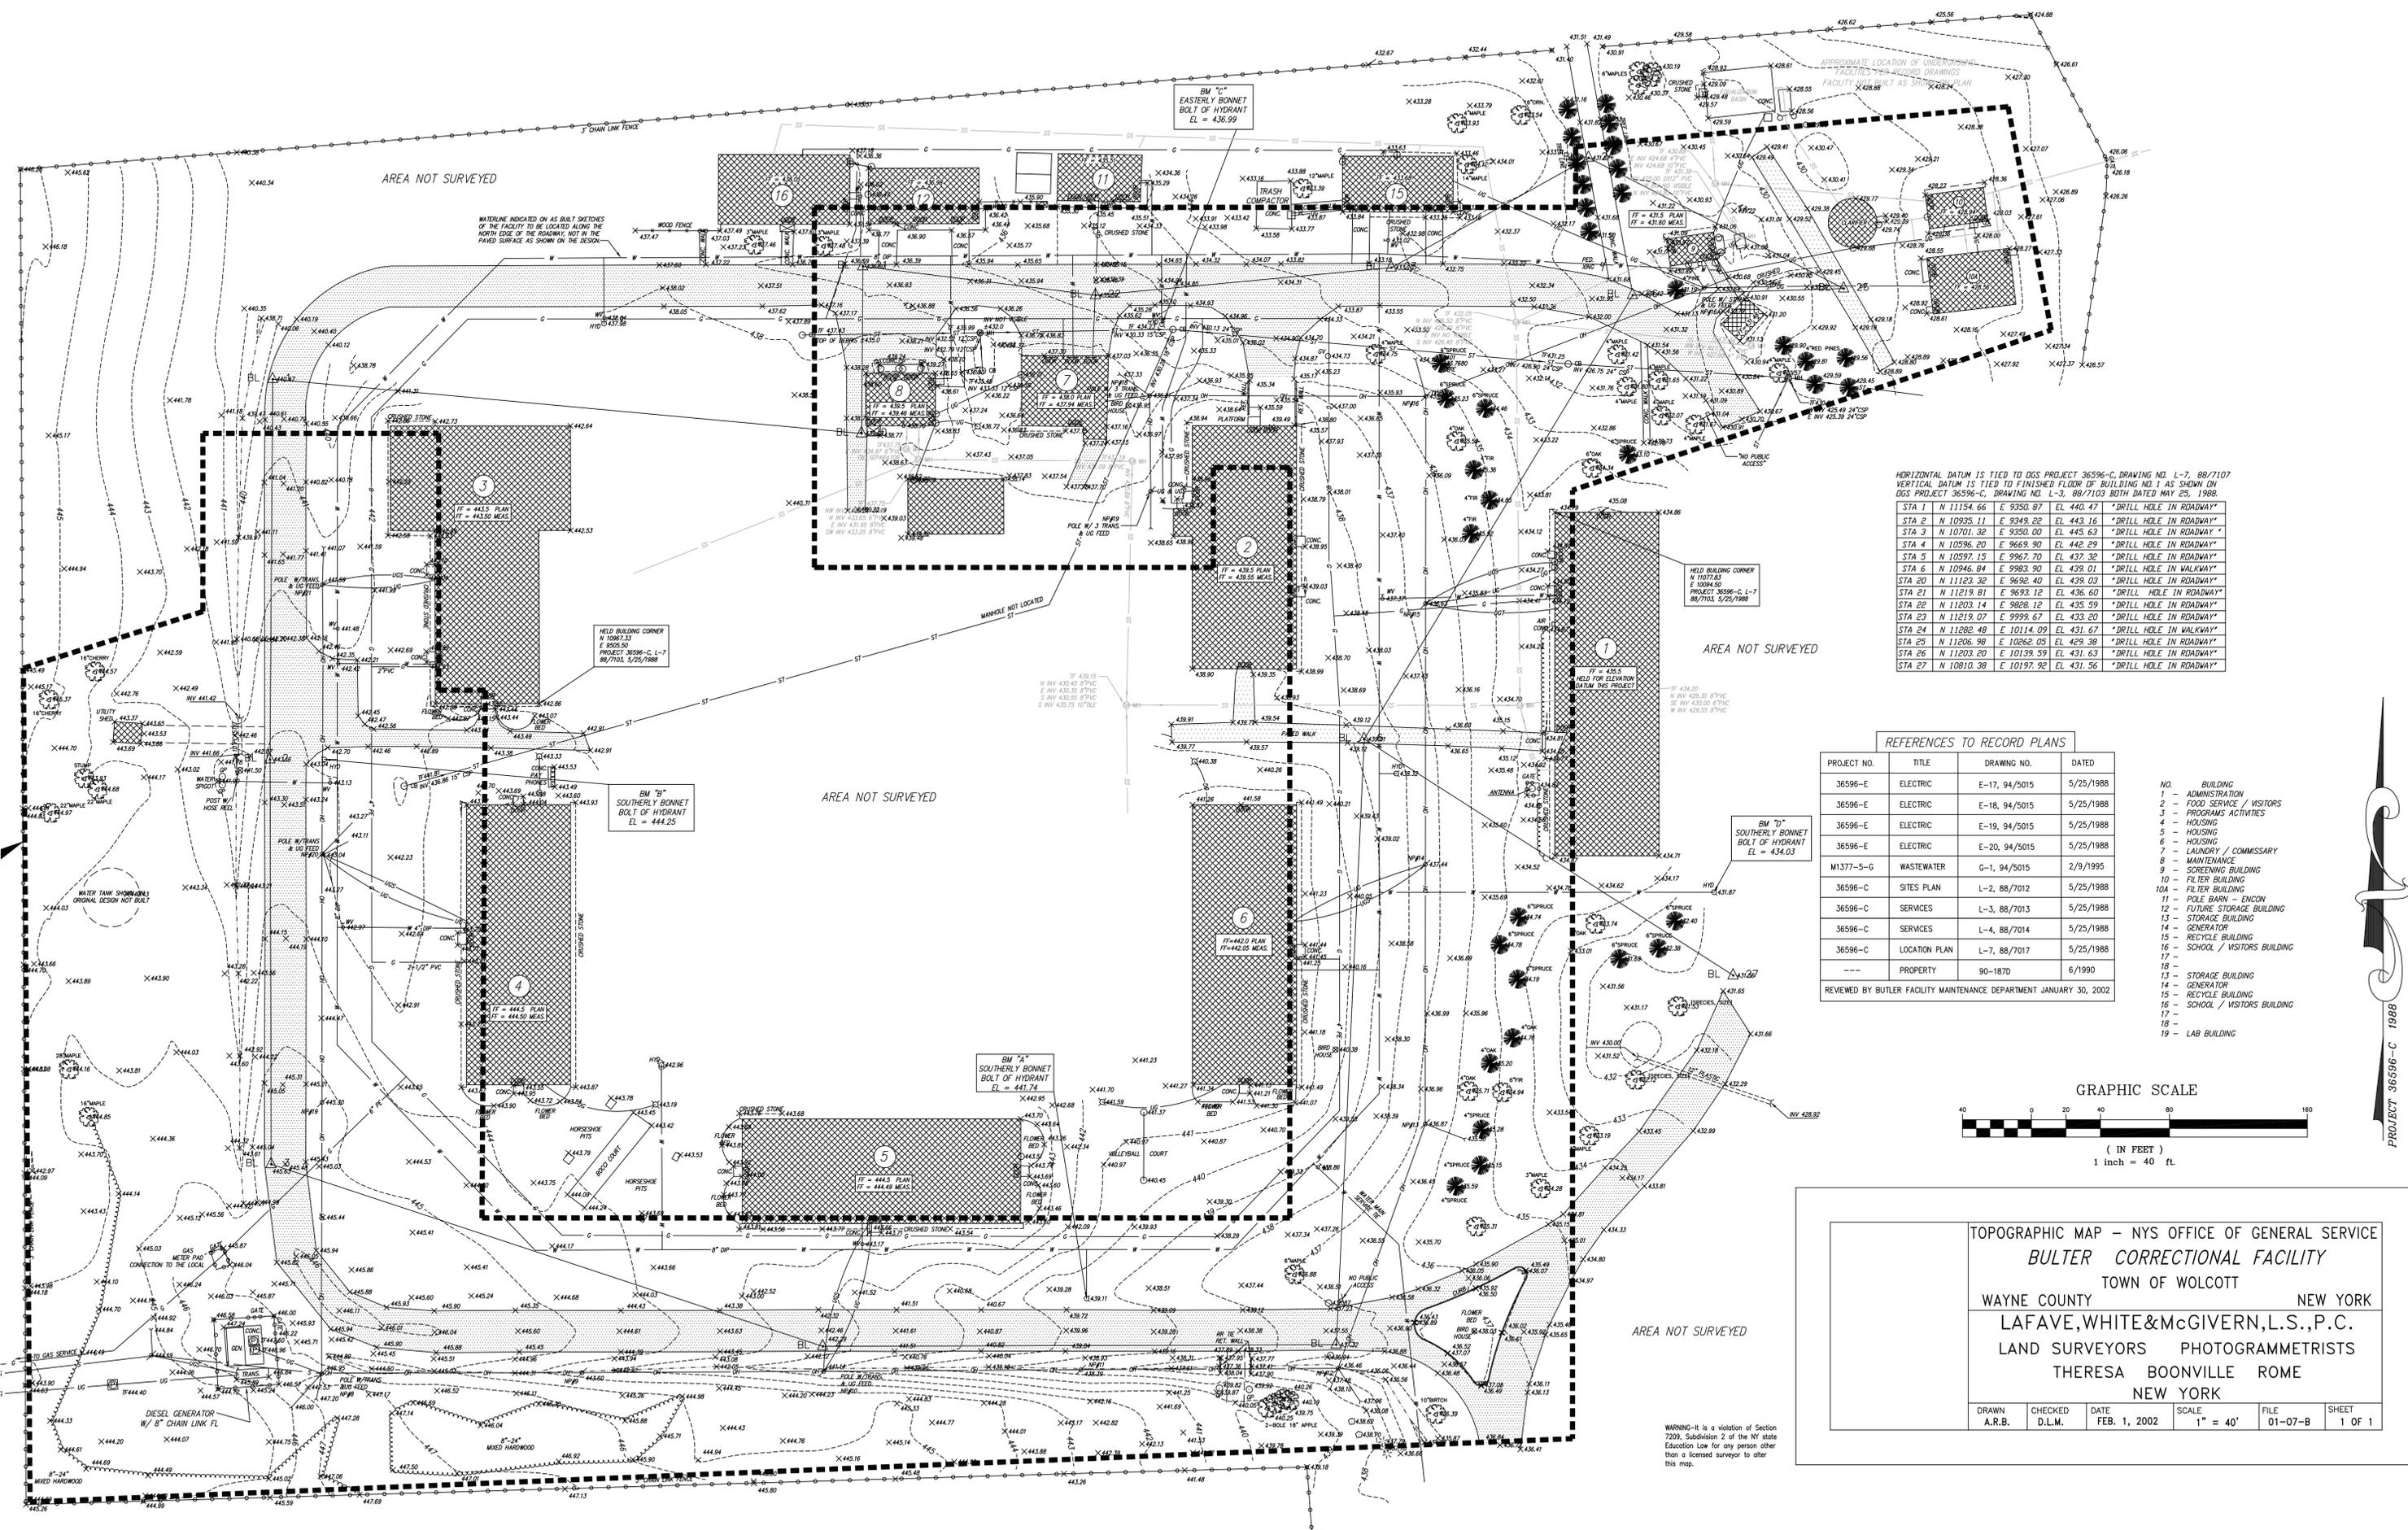


HORIZONTAL DATUM IS TIED TO OGS PROJECT 36596-C, DRAWING NO. L-7, 88/7107
 VERTICAL DATUM IS TIED TO FINISHED FLOOR OF BUILDING NO. 1 AS SHOWN ON
 OGS PROJECT 36596-C, DRAWING NO. L-3, 88/7103 BOTH DATED MAY 25, 1988.

STA	N	E	EL	DESCRIPTION
STA 1	N 1134.66	E 9350.87	EL 440.47	*DRILL HOLE IN ROADWAY*
STA 2	N 10935.11	E 9349.29	EL 443.16	*DRILL HOLE IN ROADWAY*
STA 3	N 10701.32	E 9350.00	EL 445.63	*DRILL HOLE IN ROADWAY*
STA 4	N 10596.20	E 9669.90	EL 442.29	*DRILL HOLE IN ROADWAY*
STA 5	N 10597.15	E 9967.70	EL 432.32	*DRILL HOLE IN ROADWAY*
STA 6	N 10946.84	E 9983.90	EL 439.01	*DRILL HOLE IN WALKWAY*
STA 20	N 11213.32	E 9692.40	EL 439.03	*DRILL HOLE IN ROADWAY*
STA 21	N 11219.81	E 9693.12	EL 436.60	*DRILL HOLE IN ROADWAY*
STA 22	N 11203.14	E 9828.12	EL 435.59	*DRILL HOLE IN ROADWAY*
STA 23	N 11219.07	E 9999.67	EL 433.20	*DRILL HOLE IN ROADWAY*
STA 24	N 11282.48	E 10114.09	EL 431.67	*DRILL HOLE IN WALKWAY*
STA 25	N 11206.98	E 10262.05	EL 429.38	*DRILL HOLE IN ROADWAY*
STA 26	N 11203.20	E 10139.59	EL 431.63	*DRILL HOLE IN ROADWAY*
STA 27	N 10810.38	E 10197.92	EL 431.56	*DRILL HOLE IN ROADWAY*

REFERENCES TO RECORD PLANS

PROJECT NO.	TITLE	DRAWING NO.	DATED
36596-E	ELECTRIC	E-17, 94/5015	5/25/1988
36596-E	ELECTRIC	E-18, 94/5015	5/25/1988
36596-E	ELECTRIC	E-19, 94/5015	5/25/1988
36596-E	ELECTRIC	E-20, 94/5015	5/25/1988
M1377-5-G	WASTEWATER	G-1, 94/5015	2/9/1995
36596-C	SITES PLAN	L-2, 88/7012	5/25/1988
36596-C	SERVICES	L-3, 88/7013	5/25/1988
36596-C	SERVICES	L-4, 88/7014	5/25/1988
36596-C	LOCATION PLAN	L-7, 88/7017	5/25/1988
---	PROPERTY	90-1870	6/1990

- NO. BUILDING
- 1 - ADMINISTRATION
- 2 - FOOD SERVICE / VISITORS
- 3 - PROGRAMS ACTIVITIES
- 4 - HOUSING
- 5 - HOUSING
- 6 - HOUSING
- 7 - LAUNDRY / COMMISSARY
- 8 - MAINTENANCE
- 9 - SCREENING BUILDING
- 10 - FILTER BUILDING
- 11 - POLE BARN - ENCON
- 12 - FUTURE STORAGE BUILDING
- 13 - STORAGE BUILDING
- 14 - GENERATOR
- 15 - RECYCLE BUILDING
- 16 - SCHOOL / VISITORS BUILDING
- 17 -
- 18 -
- 19 - STORAGE BUILDING
- 20 - GENERATOR
- 21 - RECYCLE BUILDING
- 22 - SCHOOL / VISITORS BUILDING
- 23 -
- 24 - LAB BUILDING

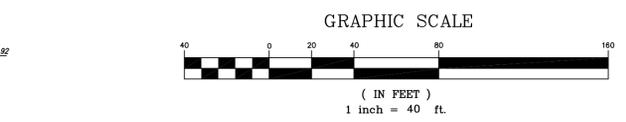

TOPOGRAPHIC MAP - NYS OFFICE OF GENERAL SERVICE
BULTER CORRECTIONAL FACILITY
 TOWN OF WOLCOTT
 WAYNE COUNTY NEW YORK
 LAFAVE, WHITE & MCGIVERN, L.S., P.C.
 LAND SURVEYORS PHOTOGRAMMETRISTS
 THERESA BOONVILLE ROME
 NEW YORK

DRAWN A.R.B.	CHECKED D.L.M.	DATE FEB. 1, 2002	SCALE 1" = 40'	FILE 01-07-B	SHEET 1 OF 1
-----------------	-------------------	----------------------	-------------------	-----------------	-----------------

WARNING - It is a violation of Section 7209, Subdivision 2 of the NY State Education Law for any person other than a licensed surveyor to alter this map.

PROJECT 36596-C 1988

Figure 2 – Property Structure List

Minimum Security Complex			Medium Security Complex		
Building	Gross square feet	Number of floors	Building	Gross square feet	Number of floors
Administration	11,991	1	Administration	12,000	1
Food Service	8,460	1	Visitors Building	3,500	1
Program/Activities/Gym	12,325	1	Activities Building	12,200	1
Inmate Housing	9,687	1	A-Dorm	10,373	1
Inmate Housing	9,687	1	B-Dorm	10,373	1
Inmate Housing	9,687	1	C-Dorm	10,318	1
Laundry-Commissary	2,148	1	School	9,800	1
Fire Safety	1,420	1	Mess Hall	8,400	1
Bar Screen	434	1	Commissary/Laundry	2,725	1
Tertiary Filter Plant	624	1	Fire Safety	450	1
Record Storage	1,548	1	Generator / Switchgear	1,400	1
Pole Barn Encon	1,564	1	Rec Yard Toilet	141	1
Storage /Frisk Building	2,147	1	Motor Pool	2,285	1
Storage	184	1	Storage	240	1
Pole Barn Recycling	2,615	1	QWL	2,560	1
School/Visitors	3,040	1	Maintenance Building	6,000	1
Escape/Pursuit	303	1	Guard Shack	73	1
Encon Tool Storage	19	1	Salt Storage	12,000	1
Encon Building	353	1	Shooting Range	161	1
Workout Pavilion	1,770	1	Pavilion	151	1
Guard Shack	42	1	Vehicle Equipment Storage	7,200	1
Emergency Generator	1,116	1	Truck Trap Guard Station	226	1
Storage	64	1	Recycling Storage	56	1
Total	81,228	23	Total	112,632	23